

LABOR AND MATERIALS

1	Copper	Connection	3/4"	\$ 2.76
1	Curb	Cock Valve	3/4" in.	\$ 3.49
1	Service box	Short 3/2 X 4 1/2		
	Old returned	Long 4 1/2 X 5 1/2		4.74
11	Ft.	3/4 in. Copper	Pipe at 35	\$ 3.85
	Nipples	in. at		\$
	Bushings	to in. at		\$
	Red'g			\$
	Inc'g	Coupl'gs to in. at		\$
	Union	in. at		\$
	Meter	in. at		\$
	Lead Joints	at		\$
	Compound Joints	at		\$
6	Hrs. Water Maint. Man-1	at		\$ 7.44
16	Hrs. Water Maint. Man-2	at 1.24		\$ 18.08
	Hrs. Labor	at 1.13		\$ 18.08
	Hrs. Labor	at		\$
	Hrs. Compressor	at		\$
	Compensation Ins.	at \$3.706 per C		\$ 1.95
	Trucking			\$ 1.00
	Pay't Patch	Outside		\$
	Tap by Gissord	11-3-52		\$
	O'head			\$
				\$ 42.31


St.
Pl.
Fort Amherst Rd. Ave. No. 41

Name of Owner

Sweeney

Labor and Mat'l. Report

Nov. 3 1952

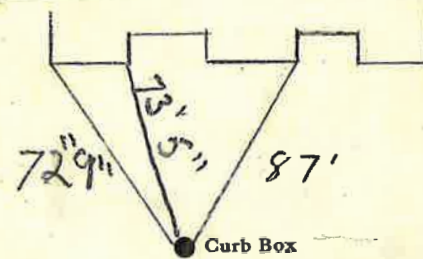

6" Main

Elev. of Main at tap 5'

Gate at ●

● Gate at

TAX ID # 302.11-3-7

● Curb Box