

LABOR AND MATERIALS

1	Copper	{ Connection	3/4"	\$	2.29
1	Lead	{			
1	Curb	{ Cock Valve	3/4 in.	\$	2.70
		{ T. S. & V.			
1	Service box	{ Short 3 1/2 x 4 1/2		\$	4.25
	Old returned	{ Long 4 1/2 x 5 1/2			
		{ Buff or Rdway			
9	Ft. 3/4 in.	{ Copper	Pipe at 35	\$	3.15
		{ G.I.			
		{ G.I.			
	Nipples	in. at		\$	
	Bushings	to in. at		\$	
	Red'g	{ Coupl'gs to in. at		\$	
	Inc'g	{			
	Union	in. at		\$	
	Meter	in. at		\$	
	Lead Joints	at		\$	
	Compound Joints	at		\$	
	Hrs. Water Maint. Man-1	at		\$	
2	Hrs. Water Maint. Man-2	at 1.02		\$	2.04
2	Hrs. Labor	at 91		\$	1.82
	Hrs. Labor	at		\$	
	Hrs. Compressor	at		\$	
	Compensation Ins. at \$ 2226 per C.			\$	
	Trucking			\$	1.09
	Pay't Patch			\$	
	Tap by Moquin			\$	
				\$	
				\$	
	O'head			\$	
				\$	17.34

90-1950


St. PL
 Ft. Amherst Rd Ave. No. 61

Name of Owner

Houseman

Labor and Mat'l. Report

July 10 1950

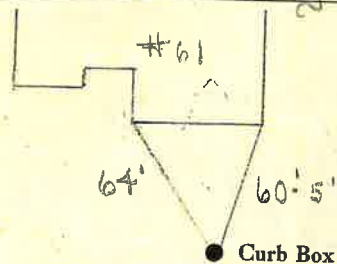

6" Main

Elev. of Main at tap 5'

Gate at ●

● Gate at

● Curb Box