

LABOR AND MATERIALS


1	Copper Lead } Connection	3/4		\$ 1.35
1	Curb { Cock Valve T. S. & V.	3/4	in.	\$ 1.80
1	Service Box Old returned	{ Short 3 1/2 x 4 1/2 Long 4 1/2 x 5 1/2 Buffer Rdway		\$ 1.70
9	Ft. 3/4 in.	{ Copper Galv Iron Cast Iron	} Pipe at 18.	\$ 1.62
	Nipples.....	in. at		\$
	Bushings.....	to..... in. at		\$
	Red'g } Inc'g }	Couplings..... to..... in. at		\$
	Union.....	in. at		\$
	Meter.....	in. at		\$
	Lead Joints at			\$
	Leadite Joints at			\$
	Hrs. Foreman at			\$
3	Hrs. Chauffeur at	62 1/2		\$ 1.88
	Hrs. Tapper at			\$
4	Hrs. Labor at	62 1/2		\$ 1.80
	Hrs. Labor at			\$
	Hrs. Compressor at			\$
	Compensation Ins.			\$ 12
	Trucking			\$ 1
	Builders Use of Water	no patch		\$
	Toply P.W.S.			\$
				\$
				\$
				\$
				\$
				\$ 11.27

87 1941

St. 65
Pl. 29
Ave. No. 29

Name of Owner

Labor and Mat'l. Report Sept 17 19 41

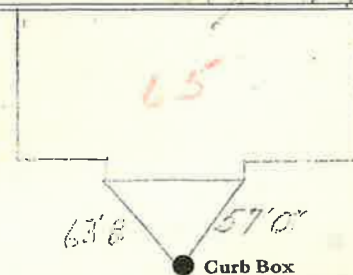

6 Main Elev. of
Main at tap 11

Gate at ● ● Gate at

● Curb Box

63' 8" 57' 0"

6 4 1/2