

LABOR AND MATERIALS

1	Copper Lead	Connection	3/4"	\$	2.71
1	Curb	Cock Valve -F.S. & V.-	3/4 in.	\$	3.83
1	Service box	Short 3 1/2 x 4 1/2		\$	4.69
	Old returned	Long 4 1/2 x 5 1/2		\$	
		Buff or Rdway		\$	
11	Ft. 3/4 in.	Copper Pipe at	45	\$	4.95
		G.I.		\$	
		G.I.		\$	
	Nipples	in. at		\$	
	Bushings	to in. at		\$	
	Red'g Inc'g	Coupl'gs to in. at		\$	
	Union	in. at		\$	
	Meter	in. at		\$	
	Lead Joints	at		\$	
	Compound Joints	at		\$	
	Maintenance Foreman			\$	
	Hrs. Water Maint. Man-1	at		\$	
	Hrs. Water Maint. Man-2	at		\$	
3	Hrs. Garage Foreman	at	1.57	\$	3.18
2	Hrs. Labor	at	1.13	\$	2.26
	Hrs. Compressor	at		\$	
	Compensation Ins.	at \$4.29 per C		\$	23
	Trucking			\$	1.50
	Pav't Patch			\$	
	Tap by Lareau	9-27-55		\$	
	O'head			\$	
				\$	23.35


St. Fort Amberst Rd.
Pl. Ave. No. 75

Name of Owner

Mortimer Task.

Labor and Mat'l. Report

Sept. 27 1955

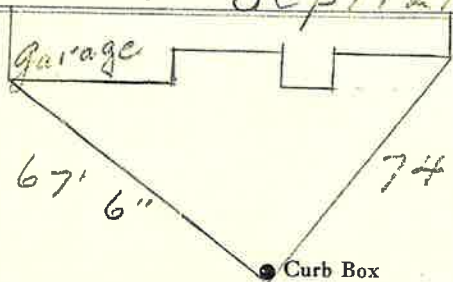

6" Main

Elev. of Main at tap 5'

Gate at •

• Gate at

• Curb Box

120