


LABOR AND MATERIALS

1	Copper Lead	Connection	3/4"	\$	3.08
1	Curb	Cock Valve T.S. & V.	3/4 in.	\$	3.89
1	Service box Old returned	Short 3 1/2 x 4 1/2 Long 4 1/2 x 5 1/2 Buff or Rdway		\$	1.32
11	Ft. 3/4 in.	Copper G.I. C.I.	Pipe at 45	\$	4.95
	Nipples	in. at		\$	
	Bushings	to in. at		\$	
	Red'g Inc'g	Coupl'gs to in. at		\$	
	Union	in. at		\$	
	Meter	in. at		\$	
	Lead Joints at			\$	
	Compound Joints at			\$	
	Maintenance Foreman			\$	
	Hrs. Water Maint. Man-1	at		\$	
	Hrs. Water Maint. Man-2	at		\$	
18	Hrs. Garage Foreman	at 1.33		\$	14.23
	Hrs. Labor	at 1.30		\$	10.40
	Hrs. Compressor at			\$	
	Compensation Ins. at	\$ 6.86 per C		\$	1.40
	Trucking			\$	1.50
	Pav't Patch			\$	
	Tap by Bureau			\$	
	Wadleigh 6-26-56			\$	
	O'head			\$	
				\$	43.77

St. Pl. Ave. No. 77
 Ft. Burhord Rd.

Name of Owner
 Scanlan

Labor and Mat'l. Report June 26 19 56

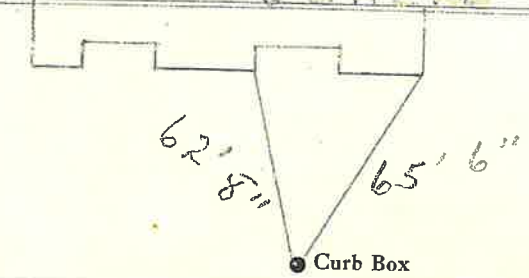

6" Main Elev. of Main at tap 5'

Gate at • Gate at •

• Curb Box