


LABOR AND MATERIALS

1	Copper Lead	Connection	3/4"	\$	3.08
1	Curb	Cock Valve T.S. & V.	3/4 in.	\$	3.89
1	Service box	Short 3 1/2 x 4 1/2		\$	4.32
	Old returned	Long 4 1/2 x 5 1/2		\$	
		Buff or Rdway		\$	
10	3/4 in.	Copper Pipe at	45	\$	4.50
		C.I.		\$	
		C.I.		\$	
	Nipples	in. at		\$	
	Bushings	to in. at		\$	
	Red'g Inc'g	Coupl'gs to in. at		\$	
	Union	in. at		\$	
	Meter	in. at		\$	
	Lead Joints at			\$	
	Compound Joints at			\$	
	Maintenance Foreman			\$	37.75
	Hrs. Water Maint. Man-1	at		\$	
8	Hrs. Water Maint. Man-2	at 1.613		\$	12.90
1	Hrs. Garage Foreman	at 1.481		\$	1.48
18	Hrs. Labor	at 1.30		\$	23.40
	Hrs. Compressor at			\$	
	Compensation Ins. at	\$ 5.686 per C		\$	2.15
	Trucking			\$	1.50
	Pay't Patch			\$	
	Tap by Gifford			\$	
		8-20-56		\$	
	O'head			\$	
				\$	57.22

St. Ft. Amherst Rd. Pl. Ave. No. 81

Name of Owner Ft. Amherst Realty Corp.

Labor and Mat'l. Report Aug. 20 1956

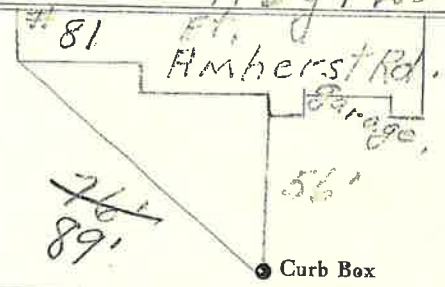

6 Main Elev. of Main at tap 5 1/2"

Gate at • Gate at

• Curb Box