


LABOR AND MATERIALS

Copper	} Connection	_____	\$ _____		
Lead					
Curb	} Cock	_____ in.	\$ _____		
				} Valve	_____
Service box	} Short 3½ x 4½	_____	\$ _____		
Old returned				Long 4½ x 5½	
18' Ft.	} Pipe at	_____ in.	\$ _____		
3/4 in.				Copper	
				C.I.	
Nipples	_____ in. at _____	\$ _____			
Bushings	_____ to _____ in. at _____	\$ _____			
Red'g	} Coupl'gs. _____ to _____ in. at _____	\$ _____			
Inc'g					
Union	_____ in. at _____	\$ _____			
Meter	_____ in. at _____	\$ _____			
Compound Joints	_____ at _____	\$ _____			
Maintenance Foreman	_____ at _____	\$ _____			
Hrs. Water Maint. Man-1	_____ at _____	\$ _____			
Hrs. Water Maint. Man-2	_____ at _____	\$ _____			
Hrs. Garage Foreman	_____ at _____	\$ _____			
Hrs. Labor	_____ at _____	\$ _____			
Hrs. Compressor	_____ at _____	\$ _____			
Trucking	_____ at _____	\$ _____			
Pav't Patch	_____ at _____	\$ _____			
		\$ _____			
		\$ _____			
Rd.
~~St.~~
~~Pt.~~
 Ave. No. 93

Name of Owner _____

Labor and Mat'l. Report 19 88

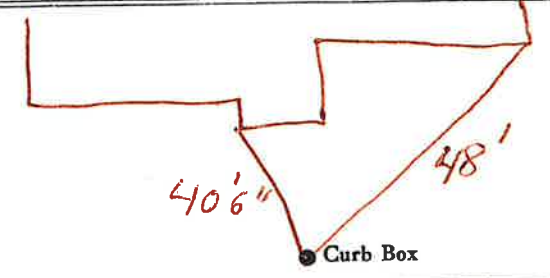

_____ Main Elev. of Main at tap 5'

Gate at ● ● Gate at

● Curb Box