

LABOR AND MATERIALS

1	Copper Lead	{ Connection	3/4		\$ 2.87
1	Curb	{ Cock Valve T.S. & V.	3/4 in.		\$ 3.62
1	Service box Old-retained	{ Short 3 1/2 x 4 1/2 Long 4 1/2 x 5 1/2 Buff or Redway			\$ 4.68
25	Ft. 3/4 in.	{ Copper G.I. G.I.	Pipe at	32	\$ 8.00
	Nipples	in. at			\$
	Bushings	to in. at			\$
	Red'g Inc'g	{ Coupl'gs	to in. at		\$
	Union	in. at			\$
	Meter	in. at			\$
	Lead Joints at				\$
	Compound Joints at				\$
2	Hrs. Water Maint. Man	1 at	1.12		\$ 2.24
	Hrs. Water Maint. Man	2 at			\$
2	Hrs. Labor	at	.91		\$ 1.82
	Hrs. Labor	at			\$
	Hrs. Compressor at				\$
	Compensation Ins. at	\$ 2.18 per C.			\$ .09
	Trucking				\$ 2.00
	Pav't Patch				\$
					\$
					\$
					\$
	O'head				\$
					\$ 25.32

Tap by Miller  
pipe by Higgins

132


FORT AMHERST RD. Ass. No. 8

Name of Owner

Cunningham

Labor and Mat'l. Report

Dec 7 1949

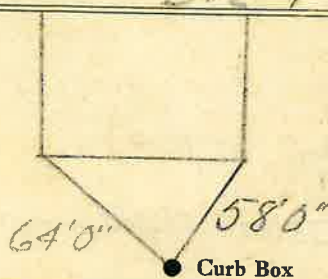

● Curb Box

6" Main

Elev. of Main at tap 5'

● Gate at

● Gate at

● Curb Box