

LABOR AND MATERIALS


1	Copper Lead	} Connection <u>3/4"</u>	\$
1	Curb Cock Valve T.S. & V.		} <u>3/4"</u> in.
1	Service box Old returned	{ Short 3-1/2 x 4-1/2 Long 4-1/2 x 5-1/2 }	
27	Ft. <u>3/4"</u> in.		} Copper Pipe at
	Nipples	in. at	
	Bushings	to in. at	\$
	Red'g		
	Inc'g		
	Union	in. at	\$
	Meter	in. at	\$
			\$
	Compound Joints at		\$
	Maintenance Foreman		\$
	Hrs. Water Maint. Man - 1 at		\$
	Hrs. Water Maint. Man - 2 at		\$
	Hrs. Garage Foreman	at	\$
	Hrs. Labor	at	\$
	Hrs. Compressor at		\$
			\$
	Trucking		\$
	Pav't Patch		\$
			\$
			\$
			\$
			\$

R.D. 22 or 24?
St. No. 10?

FT. AMHERST

Name of Owner

Labor and Mat'l. Report 19 28, NOV. 8

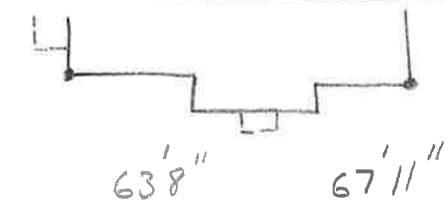

● Curb Box

6" Main

Elev. of Main at tap 4 1/2

Gate at ●

● Gate at

27' to main

● Curb Box

HOVEY
HARRY J HALL