

### LABOR AND MATERIALS


Copper	}	Connection		\$
Lead				
Curb	}	Cock		\$
		Valve		
		T. S. & V.		
Service box	}	Short 3½ x 4½		\$
Old returned		Long 4½ x 5½		
		Buff or Rdway		
Ft. ¾ in.	}	Copper		\$
		G. I.		
		G. I.		
Nipples		in. at	\$	
Bushings		to in. at	\$	
Red'g	}	Coupl'gs		\$
Inc'g			to in. at	
Union		in. at	\$	
Meter		in. at	\$	
Lead Joints at			\$	
Compound Joints at			\$	
Maintenance Foreman			\$	
Hrs. Water Maint. Man-1 at			\$	
Hrs. Water Maint. Man-2 at			\$	
Hrs. Garage Foreman at			\$	
Hrs. Labor— at			\$	
Hrs. Compressor at			\$	
Compensation Ins. at \$		per C	\$	
Trucking			\$	
Pav't Patch			\$	
			\$	
			\$	
O'head			\$	
			\$	

Rd  
St.  
Pl.  
Ave. No. 12

St. Amherst

Name of Owner \_\_\_\_\_

Labor and Mat'l. Report Oct 19 85

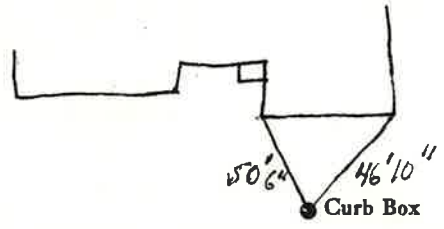

Main Elev. of  
Main at tap

Gate at ● ● Gate at

● Curb Box