

# LABOR AND MATERIALS


1	Copper } Connection	3/4	\$
1	Lead } Cock		
1	Curb } Valve	3/4 in.	\$
1	Service box	{ Short 3-1/2 x 4-1/2 }	\$
	Old returned	{ Long 4-1/2 x 5-1/2 }	\$
9	Ft. 3/4 in. { Copper		\$
		{ Gal. }	
		{ Gal. }	
	Nipples	in. at	\$
	Bushings	to in. at	\$
	Red'g		
	Inc'g		
	Union	in. at	\$
	Meter	in. at	\$
			\$
	Compound Joints at		\$
	Maintenance Foreman		\$
	Hrs. Water Maint. Man - 1 at		\$
	Hrs. Water Maint. Man - 2 at		\$
	Hrs. Garage Foreman	at	\$
	Hrs. Labor	at	\$
	Hrs. Compressor at		\$
			\$
	Trucking		\$
	Pav't Patch		\$
			\$
			\$
St. Ave. No. 13

FOURTH

Name of Owner

Labor and Mat'l. Report 19 34, OCT. 16

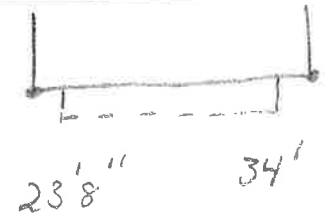

● Curb Box  
BOX DOWN 6"

6" Main

Elev. of Main at tap 42'

Gate at ● Gate at

9' to main

3/4" Copper ● Curb Box  
OLD SHUT OFF AT MAIN

DEGUIRE