

LABOR AND MATERIALS

1	Copper Lead	} Connection	3/4"	\$	
1	Curb		} 3/4 in.	\$	
				T.S. & V.	\$
1	Service box	} Short 3 1/2 x 4 1/2			
	Old returned		} Long 4 1/2 x 5 1/2		
				} Buff or Rdway	\$
26	Ft. 3/4 in.	} Copper		\$	
			} G.I.		\$
				} G.I.	\$
	Nipples	in. at		\$	
	Bushings	to in. at		\$	
	Red'g	} Coupl'gs	to in. at	\$	
	Inc'g			\$	
	Union	in. at		\$	
	Meter	in. at		\$	
	Lead Joints	at		\$	
	Compound Joints	at		\$	
	Maintenance Foreman			\$	
	Hrs. Water Maint. Man-1	at		\$	
	Hrs. Water Maint. Man-2	at		\$	
	Hrs. Garage Foreman	at		\$	
	Hrs. Labor	at		\$	
	Hrs. Compressor	at		\$	
	Compensation Ins. at \$	per C.		\$	
	Trucking			\$	
	Pav't Patch			\$	
	Tap by Gifford & Co.			\$	
				\$	
	O'head			\$	
				\$	


Tap by Gifford & Co.
6-18-57

Fourth

St. Pl. Ave. No. 14

Name of Owner
Elizabeth Scanell

Labor and Mat'l. Report June 18 1957

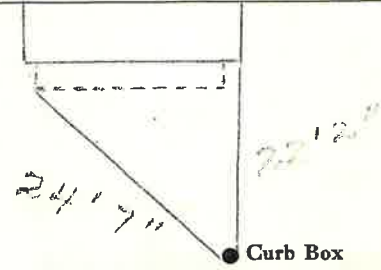

6" Main

Elev. of Main at tap 5 1/2'

Gate at • Gate at

• Curb Box