

### LABOR AND MATERIALS

Copper } Connection	_____	\$ _____
Lead } {		
Curb } Cock	_____ in.	\$ _____
} Valve		
} T. S. & V. }		
Service box { Short 3½ x 4½ }		
Old returned { Long 4½ x 5½ }		\$ _____
76" Ft. 3/4 in. { Copper } Pipe at	_____	\$ _____
} C.I.		
} C.I.		
Nipples _____ in. at		\$ _____
Bushings _____ to _____ in. at		\$ _____
Red'g } Coupl'gs _____ to _____ in. at		\$ _____
Inc'g }		
Union _____ in. at		\$ _____
Meter _____ in. at		\$ _____
_____		\$ _____
Compound Joints at		\$ _____
Maintenance Foreman		\$ _____
Hrs. Water Maint. Man—1 at		\$ _____
Hrs. Water Maint. Man—2 at		\$ _____
Hrs. Garage Foreman _____ at		\$ _____
Hrs. Labor— _____ at		\$ _____
Hrs. Compressor at		\$ _____
_____		\$ _____
Trucking _____		\$ _____
Pav't Patch _____		\$ _____
_____		\$ _____
_____		\$ _____

4<sup>th</sup>

St. Pl.  
Ave. No. 17

Name of Owner \_\_\_\_\_

Labor and Mat'l. Report \_\_\_\_\_

1996

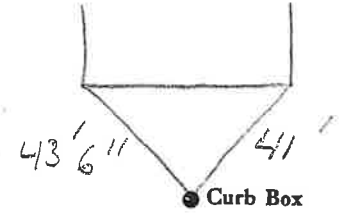

● Curb Box

Main	Elev. of Main at tap
Gate at ●	● Gate at

● Curb Box