

LABOR AND MATERIALS

1	Copper } Connection <u>3/4</u>	\$	
1	Curb } Cock Valve } <u>3/4</u> in.	\$	
1	Service box } Short <u>3-1/2</u> x <u>4-1/2</u>	\$	
	Old returned } Long <u>4-1/2</u> x <u>5-1/2</u>	\$	
26	Ft. <u>3/4</u> in. } Copper } Pipe at	\$	
	Nipples _____ in. at _____	\$	
	Bushings _____ to _____ in. at _____	\$	
	Red'g _____	\$	
	Inc'g _____	\$	
	Union _____ in. at _____	\$	
	Meter _____ in. at _____	\$	
	_____	\$	
	Compound Joints at _____	\$	
	Maintenance Foreman _____	\$	
	Hrs. Water Maint. Man - 1 at _____	\$	
	Hrs. Water Maint. Man - 2 at _____	\$	
	Hrs. Garage Foreman _____ at _____	\$	
	Hrs. Labor _____ at _____	\$	
	Hrs. Compressor at _____	\$	
	_____	\$	
	Trucking _____	\$	
	Pav't Patch _____	\$	
	_____	\$	
	_____	\$	
St. FOURTH
 Ave. No. 20

Name of Owner _____

Labor and Mat'l. Report 1936, SEPT. 12



26'-7" 34'-4"

● Curb Box

6" Main Elev. of Main at tap 5'

Gate at ● ● Gate at

● Curb Box


NEW HOUSE

LABOR AND MATERIALS

_____ Copper } Connection _____ \$ _____
 _____ Lead }
 _____ Curb } Cock } _____ in. _____ \$ _____
 _____ Valve }
 _____ T.S. & V. }
 _____ Service box { Short 3-1/2 x 4-1/2 } _____ \$ _____
 _____ Old returned { Long 4-1/2 x 5-1/2 }
 _____ Ft. _____ in. { Copper } Pipe at _____ \$ _____
 _____ G.I.
 _____ C.I.
 _____ Nipples _____ in. at _____ \$ _____
 _____ Bushings _____ to _____ in. at _____ \$ _____
 _____ Red'g
 _____ Inc'g
 _____ Union _____ in. at _____ \$ _____
 _____ Meter _____ in. at _____ \$ _____
 _____ \$ _____
 _____ Compound Joints at _____ \$ _____
 _____ Maintenance Foreman _____ \$ _____
 _____ Hrs. Water Maint. Man - 1 at _____ \$ _____
 _____ Hrs. Water Maint. Man - 2 at _____ \$ _____
 _____ Hrs. Garage Foreman _____ at _____ \$ _____
 _____ Hrs. Labor _____ at _____ \$ _____
 _____ Hrs. Compressor at _____ \$ _____
 _____ \$ _____
 _____ Trucking _____ \$ _____
 _____ Pav't Patch _____ \$ _____
 _____ \$ _____
 _____ \$ _____
FOURTH St. Pl. Ave. No. 20
 Name of Owner _____

Labor and Mat'l. Report 19 7-3-2013

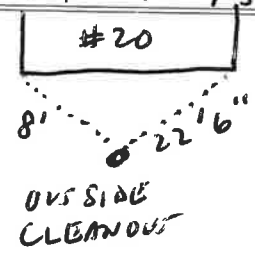

_____ Main Elev. of Main at tap _____
 Gate at ● Gate at ●

● Curb Box

● Curb Box