


LABOR AND MATERIALS

Copper } Connection _____	\$ _____
Lead } _____	\$ _____
Curb } Cock Valve } _____ in.	\$ _____
	T. S. & V. }
Service box } Short 3½ x 4½ }	
Old returned } Long 4½ x 5½ }	\$ _____
8½ Ft. ¾ in. } Copper } Pipe at _____	\$ _____
	G.I. }
	G.I. }
Nipples _____ in. at _____	\$ _____
Bushings _____ to _____ in. at _____	\$ _____
Red'g } Coupl'gs. _____ to _____ in. at _____	\$ _____
Inc'g }	
Union _____ in. at _____	\$ _____
Meter _____ in. at _____	\$ _____
_____	\$ _____
Compound Joints at _____	\$ _____
Maintenance Foreman _____	\$ _____
Hrs. Water Maint. Man—1 at _____	\$ _____
Hrs. Water Maint. Man—2 at _____	\$ _____
Hrs. Garage Foreman _____ at _____	\$ _____
Hrs. Labor _____ at _____	\$ _____
Hrs. Compressor at _____	\$ _____
_____	\$ _____
Trucking _____	\$ _____
Pav't Patch _____	\$ _____
_____	\$ _____
_____	\$ _____
_____	\$ _____
_____	\$ _____

Routh St. Pl. Ave. No. 21
 Name of Owner _____

Labor and Mat'l. Report 1926

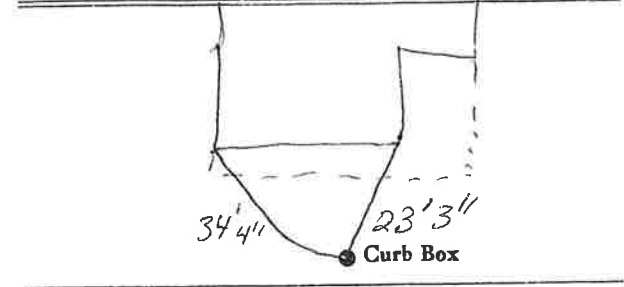

6" Main Elev. of Main at tap 42'
 Gate at ● ● Gate at

● Curb Box