


# LABOR AND MATERIALS

1	Copper <del>Lead</del>	} Connection	3/4	\$	
1	Curb	} Cock - Valve T.S. & V.	3/4 in.	\$	
1	Service box	{ Short 3-1/2 x 4-1/2 Old returned { Long 4-1/2 x 5-1/2 }		\$	
10	Ft.	{ Copper 3/4 in. } Pipe at		\$	
	Nipples	in. at		\$	
	Bushings	to in. at		\$	
	Red'g				
	Inc'g				
	Union	in. at		\$	
	Meter	in. at		\$	
				\$	
	Compound Joints at			\$	
	Maintenance Foreman			\$	
	Hrs. Water Maint. Man - 1 at			\$	
	Hrs. Water Maint. Man - 2 at			\$	
	Hrs. Garage Foreman	at		\$	
	Hrs. Labor	at		\$	
	Hrs. Compressor at			\$	
				\$	
	Trucking			\$	
	Pav't Patch			\$	
				\$	
				\$	
				\$	
				\$	

St. FOURTH  
~~No.~~ No. 23  
 Name of Owner \_\_\_\_\_

Labor and Mat'l. Report 1929, NOV. 1

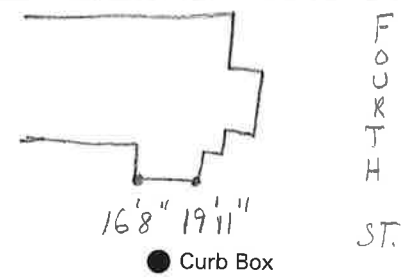

6" Main      Elev. of Main at tap 4'  
 Gate at ●      ● Gate at

● Curb Box  
 OLD TAP SHUT OFF  
 TAP ON BIG CROSS