


LABOR AND MATERIALS

<u>1</u>	Copper } Connection <u>3/4</u>	\$
<u>1</u>	Curb } Cock } <u>3/4</u> in.	\$
<u>1</u>	Service box } { Short 3-1/2 x 4-1/2 } Old returned } { Long 4-1/2 x 5-1/2 }	\$
<u>23</u>	Ft. <u>3/4</u> in. } { Copper } Pipe at	\$
	Nipples _____ in. at _____	\$
	Bushings _____ to _____ in. at _____	\$
	Red'g _____	
	Inc'g _____	
	Union _____ in. at _____	\$
	Meter _____ in. at _____	\$
	_____	\$
	Compound Joints at _____	\$
	Maintenance Foreman _____	\$
	Hrs. Water Maint. Man - 1 at _____	\$
	Hrs. Water Maint. Man - 2 at _____	\$
	Hrs. Garage Foreman _____ at _____	\$
	Hrs. Labor _____ at _____	\$
	Hrs. Compressor at _____	\$
	_____	\$
	Trucking _____	\$
	Pav't Patch _____	\$
	_____	\$
	_____	\$
St. FOURTH
 No. 26
 Name of Owner _____

Labor and Mat'l. Report 1934, OCT. 24

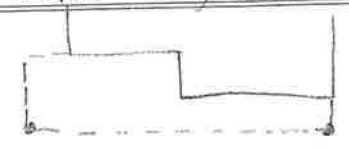

24' 17'-5"

● Curb Box

6" Main Elev. of Main at tap 4 1/2'
 Gate at ● ● Gate at

● Curb Box

OLD TAP SHUT OFF AT MAIN
 HEALY