


LABOR AND MATERIALS

Copper	} Connection				
Lead	}		\$		
Curb	{ Cock	} in.	\$		
	{ Valve				
	{ T.S. & V.				
Service box	{ Short 3-1/2 x 4-1/2	}	\$		
Old returned	{ Long 4-1/2 x 5-1/2				
42 Ft. 6 in.	{ Copper	} Pipe at	\$		
	{ Gal.				
	{ Gal.				
Nipples		in. at	\$		
Bushings		to in. at	\$		
Red'g					
Inc'g					
Union		in. at	\$		
Meter		in. at	\$		
			\$		
Compound Joints at			\$		
Maintenance Foreman			\$		
Hrs. Water Maint. Man - 1 at			\$		
Hrs. Water Maint. Man - 2 at			\$		
Hrs. Garage Foreman		at	\$		
Hrs. Labor		at	\$		
Hrs. Compressor at			\$		
			\$		
Trucking			\$		
Pav't Patch			\$		
			\$		
			\$		
St. FOURTH
Pl. Ave. No. 28

Name of Owner _____

Labor and Mat'l. Report 10-4-22-2013

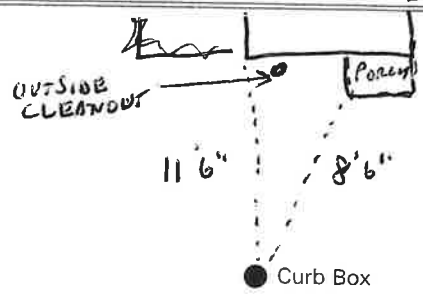

Main Elev. of Main at tap _____

Gate at ● ● Gate at

● Curb Box