


LABOR AND MATERIALS

1	Copper } Connection $\frac{3}{4}$	\$
1	Lead } Cock Valve } $\frac{3}{4}$ in.	\$
1	T.S. & V. }	\$
	Service box { Short 3-1/2 x 4-1/2 }	\$
	Old returned { Long 4-1/2 x 5-1/2 }	\$
24	Ft. $\frac{3}{4}$ in. { Copper } Pipe at	\$
		\$
	Nipples _____ in. at _____	\$
	Bushings _____ to _____ in. at _____	\$
	Red'g _____	\$
	Inc'g _____	\$
	Union _____ in. at _____	\$
	Meter _____ in. at _____	\$
	_____	\$
	Compound Joints at _____	\$
	Maintenance Foreman _____	\$
	Hrs. Water Maint. Man - 1 at _____	\$
	Hrs. Water Maint. Man - 2 at _____	\$
	Hrs. Garage Foreman _____ at _____	\$
	Hrs. Labor _____ at _____	\$
	Hrs. Compressor at _____	\$
	_____	\$
	Trucking _____	\$
	Pav't Patch _____	\$
	_____	\$
	_____	\$
St. FOURTH
 Ave. No. 30
 Name of Owner _____

Labor and Mat'l. Report 19 39, OCT. 24

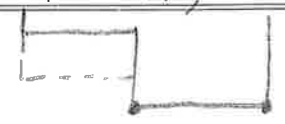

19-6 18-10

● Curb Box

6" Main Elev. of Main at tap 4 1/2'

Gate at ● ● Gate at

● Curb Box

OLD SHUT OFF AT MAIN

THOMSON