


LABOR AND MATERIALS

1	Copper } Connection $\frac{3}{4}$	\$
1	Curb } Cock Valve } $\frac{3}{4}$ in.	\$
1	Service box { Short 3-1/2 x 4-1/2 } Old returned { Long 4-1/2 x 5-1/2 }	\$
9	Ft. $\frac{3}{4}$ in. { Copper } Pipe at	\$
	Nipples _____ in. at	\$
	Bushings _____ to _____ in. at	\$
	Red'g	
	Inc'g	
	Union _____ in. at	\$
	Meter _____ in. at	\$
	_____	\$
	Compound Joints at	\$
	Maintenance Foreman	\$
	Hrs. Water Maint. Man - 1 at	\$
	Hrs. Water Maint. Man - 2 at	\$
	Hrs. Garage Foreman _____ at	\$
	Hrs. Labor _____ at	\$
	Hrs. Compressor at	\$
	_____	\$
	Trucking _____	\$
	Pav't Patch _____	\$
	_____	\$
	_____	\$
	_____	\$
	_____	\$

St. FOURTH
Ave. No. 5
Name of Owner _____

Labor and Mat'l. Report 1930, OCT. 4

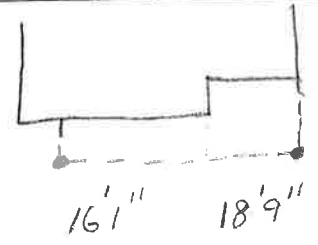

● Curb Box

6" Main Elev. of Main at tap 4 1/2'

Gate at ● ● Gate at

● Curb Box

OLD TAP DISCONNECTED