


### LABOR AND MATERIALS

1	Copper	Connection	3/4"	\$ 3.08
	<del>Lead</del>	Cock Valve T.S. & V.	3/4 in.	\$ 3.99
1	Curb			
1	Service box	Short 3 1/2 x 4 1/2		\$ 4.32
	Old returned	Long 4 1/2 x 5 1/2		
		Buff or Rdway		
11	Ft.	Copper	Pipe at 45	\$ 4.95
	3/4 in.	G.I.		
		G.I.		
	Nipples	in. at		\$
	Bushings	to in. at		\$
	Red'g	Coupl'gs	to in. at	\$
	Inc'g			
	Union	in. at		\$
	Meter	in. at		\$
	Lead Joints at			\$ 74
	Compound Joints at			\$ 26
	Maintenance Foreman			\$ 2
	Hrs. Water Maint. Man-1 at			\$
3	Hrs. Water Maint. Man-2 at	1.613		\$ 4.84
3	Hrs. Garage Foreman lab. at	1.30		\$ 3.90
18	Hrs. Labor S. Brnp. at	1.00		\$ 18.00
	Hrs. Compressor at			\$
	Compensation Ins. at \$ 5.86 per C			\$ 1.52
	Trucking			\$ 1.50
	Pay't Patch			\$ 9.00
	Tap by Gifford & Co			\$
	7-20-56			\$
	O'head			\$
				\$ 55.10

St. \_\_\_\_\_  
 Pl. \_\_\_\_\_  
 Ave. No. 33

Name of Owner \_\_\_\_\_  
Parker

Labor and Mat'l. Report July 20 19 56

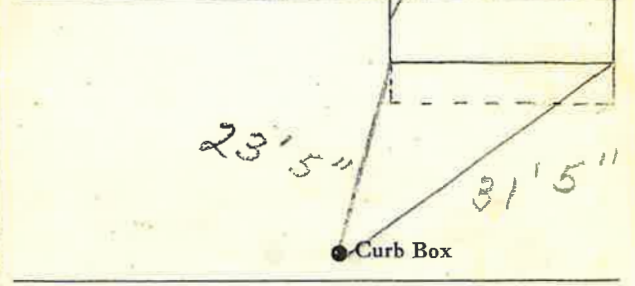

● Curb Box

6" Main Elev. of Main at tap 5'

Gate at ● ● Gate at

TAX ID # 309.11-11-17

● Curb Box

