


LABOR AND MATERIALS

1 ~~Copper~~ } Connection $\frac{1}{2}$ \$ _____
 Lead }
 1 Curb } Cock } $\frac{3}{4}$ in. \$ _____
 Valve }
 T.S. Box }
 1 Service box { Short 3-1/2 x 4-1/2 } \$ _____
 Old returned { Long 4-1/2 x 5-1/2 }
 20 Ft. $\frac{3}{4}$ in. { ~~Copper~~ } Pipe at \$ _____
 G.I. }
 Gal. }
 _____ Nipples _____ in. at \$ _____
 _____ Bushings _____ to _____ in. at \$ _____
 _____ Red'g _____
 _____ Inc'g _____
 _____ Union _____ in. at \$ _____
 _____ Meter _____ in. at \$ _____
 _____ \$ _____
 _____ Compound Joints at \$ _____
 _____ Maintenance Foreman \$ _____
 _____ Hrs. Water Maint. Man - 1 at \$ _____
 _____ Hrs. Water Maint. Man - 2 at \$ _____
 _____ Hrs. Garage Foreman _____ at \$ _____
 _____ Hrs. Labor _____ at \$ _____
 _____ Hrs. Compressor at \$ _____
 _____ \$ _____
 _____ Trucking \$ _____
 _____ Pav't Patch \$ _____
 _____ \$ _____
 _____ \$ _____
St. _____
 Ave. No. 34
FOURTH
 Name of Owner _____

Labor and Mat'l. Report 19 21, JULY 12

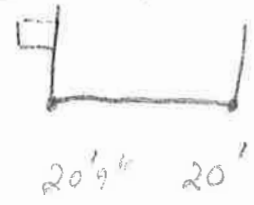

● Curb Box

_____ Main Elev. of Main at tap _____
 Gate at ● _____ Gate at ● _____

TAX ID # 309.11-13-6

● Curb Box

20' 9" 20'