

LABOR AND MATERIALS


1	Copper	Connection	3/4	\$	_____
1	Curb	Cock Valve T.S. & V.	3/4 in.	\$	_____
1	Service box	Short 3-1/2 x 4-1/2		\$	_____
	Old returned	Long 4-1/2 x 5-1/2		\$	_____
10	Ft.	3/4 in. Copper	Pipe at	\$	_____
_____	Nipples	_____ in.	at	\$	_____
_____	Bushings	_____ to _____ in.	at	\$	_____
_____	Red'g				
_____	Inc'g				
_____	Union	_____ in.	at	\$	_____
_____	Meter	_____ in.	at	\$	_____
_____				\$	_____
_____	Compound Joints	at		\$	_____
_____	Maintenance Foreman			\$	_____
_____	Hrs. Water Maint. Man - 1	at		\$	_____
_____	Hrs. Water Maint. Man - 2	at		\$	_____
_____	Hrs. Garage Foreman	at		\$	_____
_____	Hrs. Labor	at		\$	_____
_____	Hrs. Compressor	at		\$	_____
_____				\$	_____
_____	Trucking			\$	_____
_____	Pav't Patch			\$	_____
_____				\$	_____
_____				\$	_____
_____				\$	_____
_____				\$	_____

FOURTH

St. ~~35~~ No. 35

Name of Owner _____

Labor and Mat'l. Report 1929, APR. 22

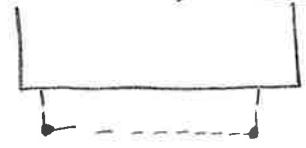

16 3/4" 21 1/4"

● Curb Box

6" Main

Elev. of Main at tap 5

Gate at ●

● Gate at

● Curb Box

OLD TAP DISCONNECTED