

LABOR AND MATERIALS


1	Copper } Connection	3/4	\$	
	Lead } }			
1	Curb } Cock	3/4 in.	\$	
	Valve } }			
	T.C. & V. }			
1	Service box { Short 3-1/2 x 4-1/2		\$	
	Old returned { Long 4-1/2 x 5-1/2			
10	Ft. 3/4 in. { Copper		\$	
	Pipe at			
	Nipples	in. at	\$	
	Bushings	to in. at	\$	
	Red'g			
	Inc'g			
	Union	in. at	\$	
	Meter	in. at	\$	
			\$	
	Compound Joints at		\$	
	Maintenance Foreman		\$	
	Hrs. Water Maint. Man - 1 at		\$	
	Hrs. Water Maint. Man - 2 at		\$	
	Hrs. Garage Foreman	at	\$	
	Hrs. Labor	at	\$	
	Hrs. Compressor at		\$	
			\$	
	Trucking		\$	
	Pav't Patch		\$	
			\$	
			\$	
FOURTH

St. No. 37

Name of Owner
TAX ID # 309.11-11-15

Labor and Mat'l. Report 19 30, APRIL 8

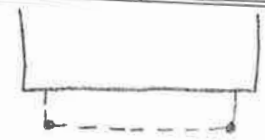

16-4 24-4

● Curb Box

6" Main

Elev. of Main at tap 5'

Gate at ●

● Gate at

● Curb Box

OLD TAP DISCONNECTED