


### LABOR AND MATERIALS

1	Copper } Connection <u>3/4</u>	\$
1	Curb } Cock } <u>3/4</u> in.	\$
1	Service box } { Short 3-1/2 x 4-1/2 } Old returned } { Long 4-1/2 x 5-1/2 }	\$
28	Ft. <u>3/4</u> in. } { Copper } Pipe at	\$
	Nipples _____ in. at _____	\$
	Bushings _____ to _____ in. at _____	\$
	Red'g _____	
	Inc'g _____	
	Union _____ in. at _____	\$
	Meter _____ in. at _____	\$
	_____	\$
	Compound Joints at _____	\$
	Maintenance Foreman _____	\$
	Hrs. Water Maint. Man - 1 at _____	\$
	Hrs. Water Maint. Man - 2 at _____	\$
	Hrs. Garage Foreman _____ at _____	\$
	Hrs. Labor _____ at _____	\$
	Hrs. Compressor at _____	\$
	_____	\$
	Trucking _____	\$
	Pav't Patch _____	\$
	_____	\$
	_____	\$
St. FOURTH Ave. No. 41

Name of Owner \_\_\_\_\_  
TAX ID # 309.11-11-13

Labor and Mat'l. Report 1937, FEB. 25

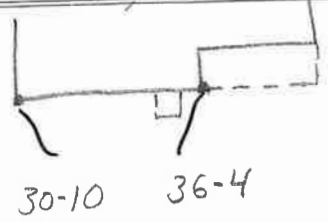

● Curb Box

6" Main

Elev. of Main at tap 5'

Gate at ●

● Gate at

● Curb Box

NEW TAP

## LABOR AND MATERIALS

_____	Copper } Connection _____	\$ _____
_____	Lead } _____	\$ _____
_____	Curb } Cock _____	\$ _____
_____	Valve } _____ in. _____	\$ _____
_____	T.S. & V. } _____	\$ _____
_____	Service box { Short 3-1/2 x 4-1/2 } _____	\$ _____
_____	Old returned { Long 4-1/2 x 5-1/2 } _____	\$ _____
_____	Ft. _____ in. { Copper } Pipe at _____	\$ _____
_____	{ G.I. } _____	\$ _____
_____	{ C.I. } _____	\$ _____
_____	Nipples _____ in. at _____	\$ _____
_____	Bushings _____ to _____ in. at _____	\$ _____
_____	Red'g _____	\$ _____
_____	Inc'g _____	\$ _____
_____	Union _____ in. at _____	\$ _____
_____	Meter _____ in. at _____	\$ _____
_____	_____	\$ _____
_____	Compound Joints at _____	\$ _____
_____	Maintenance Foreman _____	\$ _____
_____	Hrs. Water Maint. Man - 1 at _____	\$ _____
_____	Hrs. Water Maint. Man - 2 at _____	\$ _____
_____	Hrs. Garage Foreman _____ at _____	\$ _____
_____	Hrs. Labor _____ at _____	\$ _____
_____	Hrs. Compressor at _____	\$ _____
_____	_____	\$ _____
_____	Trucking _____	\$ _____
_____	Pav't Patch _____	\$ _____
_____	_____	\$ _____
_____	_____	\$ _____
41 4th St. Pt. No.

Name of Owner 4th St.

Labor and Mat'l. Report 8-2007

LEFT SIDE OF HOUSE

GROUND OUTSIDE CLEAN OUT

39'4"

49'4"

Curb Box

STAPLE ST Elev. of Main at tap

Gate at ● Gate at ●

● Curb Box

INSTALLED NEW CLEAN-OUT ON STAPLE ST. SIDE

