


**Labor and Materials**

1	Copper } Connection.....	3	\$ 2.60
	Lead } .....		
1	Curb } Cock } .....	1	\$ 2.27
	Valve } .....		
	T. S. & V. } .....		
1	Service Box } Short 3/4 x 1/2 } .....	1	\$ 1.38
	Old returned } .....		
	Both or Rd Way } .....		
6	Ft. } in. } Copper } Pipe at.....	3	\$ 1.08
	Cast Iron } .....		
	Nipples.....		\$
	Bushings.....		\$
	Red'g } Couplings.....		\$
	Inc'g } .....		\$
	Union.....		\$
	Meter.....		\$
	Lbs. Br. Stone at.....		\$
	Lbs. Sand at.....		\$
	Bags Cement at.....		\$
	Paving Brick } Mack } at.....		\$
	Red } .....		\$
	Asphalt } .....		\$
	Lead Joints at.....		\$
	Leadite Joints at.....		\$
2	Hrs. Foreman at.....	1.25	\$
2	Hrs. Common Labor at.....	.90	\$
	Hrs. Common Labor at.....		\$
	Hrs. Mason at.....		\$
	Hrs. Mason's Helper at.....		\$
	Hrs. Compressor at.....		\$
	Compensation Ins.....	.07	\$
	Trucking.....	1.00	\$
	Builders' Use of Water.....	no patch	\$
	<b>Total</b> \$.....	<b>10.55</b>	

31-90

Labor and Material Report August 1 1931

Lot 16 Thomas Subdiv. 4<sup>th</sup> St

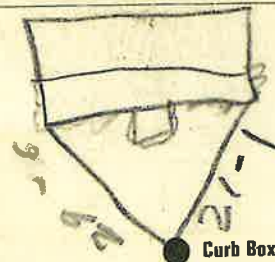

6 Main

Elev of Main at tap 5

Gate at ●

● Gate at

● Curb Box

New House