

LABOR AND MATERIALS

1 Copper Connection $\frac{3}{4}$ \$ 1.23
 1 Curb { Cock Valve } in. $\frac{3}{4}$ \$ 1.68
 { T.S. & V. }
 1 Service Box { Short $3\frac{1}{2} \times 4\frac{1}{2}$ }
 Old returned { Long $4\frac{1}{2} \times 5\frac{1}{2}$ } \$ 1.75
 { Buff. or Rdway }
 28 Ft. 0 in. $\frac{3}{4}$ { Copper } Pipe at .15 \$ 4.20
 { Gal. Iron }
 { Cast Iron }
 Nipples in. at \$
 Bushings to in. at \$
 Red'g } Couplings to in. at \$
 Inc'g }
 Union in. at \$
 Meter in. at \$
 Lead Joints at \$
 Leadite Joints at \$
 Hrs. Foreman at \$
 3 Hrs. Chauffeur at $62\frac{1}{2}$ \$ 1.88
 7 Hrs. Tapper at 45 \$ 4.37
 6 Hrs. Labor at 45 \$ 2.70
 Hrs. Labor at \$
 Hrs. Compressor at \$
 Compensation Ins. \$.28
 Trucking \$ 1.00
 Builders Use of Water $\frac{1}{2}$ Patel (Sewer) \$ 2.50
 Tully H. H. Call \$
 \$ 21.59

9 9 - 1938

St.

Pl.

51 Fourth


Ave. No.

Name of Owner

Dolan

Labor and Mat'l. Report

Aug 23 1938

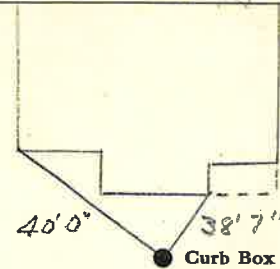

6" Main

Elev. of Main at tap 5'

Gate at ●

● Gate at

● Curb Box

New House

No Measurements