

### Labor and Materials

1	Copper Lead	Connection	3/4		\$ 1.23
1	Curb	Cock Valve T. S. & V.	3/4 in		\$ 1.68
1	Service Box Old returned	Short 3 1/2 x 4 1/2 Long 4 1/2 x 5 1/2 Buff. or Rdway			\$ 1.75
9	Ft. 3/4 in.	Copper Galv-iron Cast-iron	Pipe at		\$ 1.35
	Nipples	in. at			\$
	Bushings	to	in. at		\$
	Red'g Inc'g	Conplings	to	in. at	\$
	Union	in. at			\$
	Meter	in. at			\$
	Lead Joints at				\$
	Leadite Joints at				\$
	Hrs. Foreman at				\$
2	Hrs. Chauffeur at	6 1/2 hr			\$ 1.25
4	Hrs. Tapper at				\$ 2.50
4	Hrs. Labor at	45			\$ 1.80
	Hrs. Labor at				\$
	Hrs. Compressor at				\$
	Compensation Ins.				\$ .17
	Trucking				\$ 1.00
	Builders Use of Water				\$
	Twp by Blossell				\$
	1 hr of Patch (Sewer)				\$ 2.50
					\$
					\$
	<u>\$ 15.23</u>				

26 - 1938

St.

54

Fourth

Pr

Ave. No.


Name of Owner

Thibault

Labor and Mat'l. Report

May 31

19 38

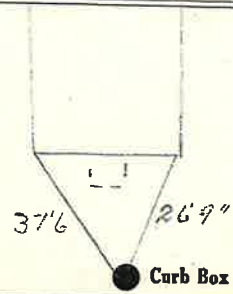

6" Main

Elev. of

Main at tap 5'

Gate at ●

● Gate at

● Curb Box

New

TH