

LABOR AND MATERIALS

Copper	} Connection	_____	\$ _____
Lead			
Curb	} Cock Valve T. S. & V. }	_____ in.	\$ _____
Service box	} Short 3½ x 4½ } Long 4½ x 5½ } Buff or Rdway }	_____	\$ _____
Old returned			
9 Ft. ¾ in.	} Copper G.I. }	Pipe at _____	\$ _____
Nipples	in. at _____	\$ _____	
Bushings	to _____ in. at _____	\$ _____	
Red'g } Inc'g }	Coupl'gs _____ to _____ in. at _____	\$ _____	
Union	in. at _____	\$ _____	
Meter	in. at _____	\$ _____	
Lead Joints	at _____	\$ _____	
Compound Joints	at _____	\$ _____	
Maintenance Foreman	_____	\$ _____	
Hrs. Water Maint. Man-1	at _____	\$ _____	
Hrs. Water Maint. Man-2	at _____	\$ _____	
Hrs. Garage Foreman	at _____	\$ _____	
Hrs. Labor	at _____	\$ _____	
Hrs. Compressor	at _____	\$ _____	
Compensation Ins.	at \$ _____ per C	\$ _____	
Trucking	_____	\$ _____	
Pav't Patch	_____	\$ _____	
		\$ _____	
		\$ _____	
O'head	_____	\$ _____	
		\$ _____	

4th


St. Pl. Ave. No. 58

Name of Owner

W. Keyser

Labor and Mat'l. Report

Nov 1987

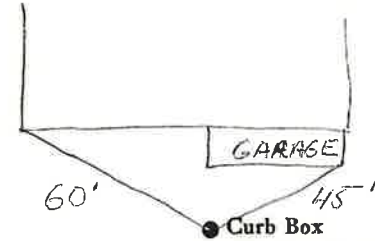

Main

Elev. of Main at tap \_\_\_\_\_

Gate at ●

● Gate at

● Curb Box