

LABOR AND MATERIALS

1	Copper Lead	Connection	$\frac{3}{4}$	\$ 1.23
1	Curb	Cock Valve T. S. & V.	$\frac{3}{4}$ in.	\$ 1.68
1	Service Box	}	Short $3\frac{1}{2} \times 4\frac{1}{2}$	\$ 1.54
	Old returned		Long $4\frac{1}{2} \times 5\frac{1}{2}$	
			Buff. on Rdway	
28	Ft.	$\frac{3}{4}$ in.	}	Pipe at 17 \$ 4.76
	Nipples	in. at		\$
	Bushings	to in. at		\$
	Red'g Inc'g	}	Couplings to in. at	\$
	Union	in. at		\$
	Meter	in. at		\$
	Lead Joints	at		\$
	Leadite Joints	at		\$
	Hrs. Foreman	at		\$
$\frac{3}{4}$	Hrs. Chauffeur	at $6\frac{1}{2}$		\$ 1.88
	Hrs. Tapper	at		\$
4	Hrs. Labor	at $4\frac{1}{2}$		\$ 1.80
	Hrs. Labor	at		\$
	Hrs. Compressor	at		\$
	Compensation Ins.			\$ 12
	Trucking			\$ 1.00
	Builders Use of Water	Patch		\$ 5.00
	Taps by Person			\$
				\$
				\$
				\$ 19.01

59 -- 1939

St.

Fourth

Ave. No.

61


Name of Owner

Edward Ball

Labor and Mat'l. Report

Aug 21

1939

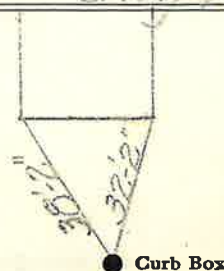

● Curb Box

6 Main

Elev. of Main at tap 5

Gate at ●

● Gate at

● Curb Box

New House

W.