


LABOR AND MATERIALS

1	Copper	} Connection	3/4"	\$
	Lead			
1	Curb	} Cock Valve T. S. & V.	3/4" in.	\$
1	Service box	} Short 3 1/2 x 4 1/2 Long 4 1/2 x 5 1/2 Buff or Rdway		\$
	Old returned			
25	Ft.	} Copper G. I. C. I.	3/4" in.	\$
	Nipples	in. at		\$
	Bushings	to in. at		\$
	Red'g } Inc'g }	Coupl'gs to in. at		\$
	Union	in. at		\$
	Meter	in. at		\$
	Lead Joints	at		\$
	Compound Joints	at		\$
	Maintenance Foreman			\$
	Hrs. Water Maint. Man-1	at		\$
	Hrs. Water Maint. Man-2	at		\$
	Hrs. Garage Foreman	at		\$
	Hrs. Labor	at		\$
	Hrs. Compressor	at		\$
	Compensation Ins. at \$	per C		\$
	Trucking			\$
	Pav't Patch			\$
	Tap by Laurent Co			\$
				\$
				\$
	O'head			\$
				\$

Fourth St. Ave. No. 8

Name of Owner  
Philip Springs

Labor and Mat'l. Report Aug. 17 1965

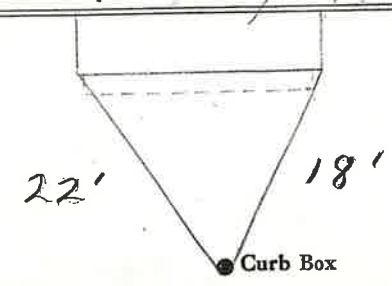

6" Main Elev. of Main at tap 5'

Gate at • Gate at  
25' to main

3/4" copper • Curb Box