

LABOR AND MATERIALS

Copper Lead	Connection		\$
2 Curb	{ Cock Valve T-S & V. } $\frac{3}{4}$ in. 16 Bra		\$ 3.36
1 Service Box	{ Short $3\frac{1}{2} \times 4\frac{1}{2}$ Long $4\frac{1}{2} \times 5\frac{1}{2}$ Buff. or Rdway }		\$ 1.54
Old returned			
30 Ft. $\frac{3}{4}$ in.	{ Copper Galv. Iron Cast Iron } Pipe at 17		\$ 5.10
1 Nipples $1\frac{1}{2}$ in.	at 6" long		\$ 11
1 Bushings	to in. at		\$
1 1/2 Red'g } Couplings	to in. at		\$ 20
1 Union $1\frac{1}{2}$ in.	at		\$ 52
1 Meter $2\frac{1}{2}$ in.	at $1\frac{1}{2} \times 3\frac{1}{2}$ Tee		\$ 35
1 Lead Joints at $3\frac{1}{4}$	Brass Nip 4' long		\$ 14
1 Leadite Joints at	3 Couplings		\$
Hrs. Foreman at	9 Hrs		\$ 30
3 Hrs. Chauffeur at	6 1/2 Hrs		\$ 1.88
Hrs. Tapper at			\$
14 Hrs. Labor at	45		\$ 6.30
Hrs. Labor at			\$
Hrs. Compressor at			\$
Compensation Ins.			\$ 25
Trucking			\$ 1-
Builders Use of Water			\$
Taphy Miller			\$
Patch 1/2 Sewer Dept			\$ 2.50
			\$
			\$ 23.55

18 - 1939

St.

Tt.

Fourth


Ave. No. 65-

Name of Owner

Ball

Labor and Mat'l. Report

May 8 1939

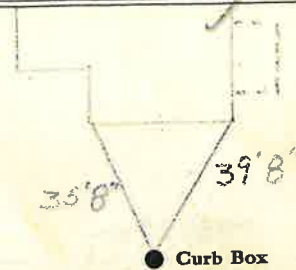

1 1/2 Main

Elev. of Main at tap 5-

Gate at ●

● Gate at

● Curb Box

New Top