

LABOR AND MATERIALS


Copper } Connection ----- \$
 Lead }
 Curb { Cock } ----- in. ----- \$
 { Valve }
 { T. S. & V. }
 Service Box { Short 3/2x4 1/2 } ----- \$
 Old returned { Long 4 1/2x5 1/2 }
 { Buff. or Rdway }
 11 Ff. 3/4 in. { Copper } Pipe at ----- \$
 { Galv Iron }
 { Cast Iron }
 Nipples ----- in. at ----- \$
 Bushings ----- to ----- in. at ----- \$
 Red'g } Couplings ----- to ----- in. at ----- \$
 Inc'g }
 Union ----- in. at ----- \$
 Meter ----- in. at ----- \$
 Lead Joints at ----- \$
 Leadite Joints at ----- \$
 Hrs. Foreman at ----- \$
 Hrs. Chauffeur at ----- \$
 Hrs. Tapper at ----- \$
 Hrs. Labor at ----- \$
 Hrs. Labor at ----- \$
 Hrs. Compressor at ----- \$
 Compensation Ins. ----- \$
 Trucking ----- \$
 Builders Use of Water ----- \$
 ----- \$
 ----- \$
St.
 Pt.
 Ave. No. 66

Fourth

Name of Owner
 TAX ID # 309.11-12-6

Labor and Mat'l. Report SEP 13 1940 19

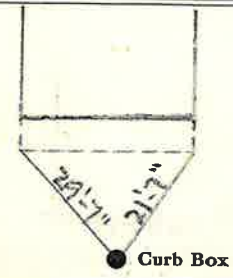

Main ----- Elev. of Main at tap -----
 Gate at ● ----- Gate at ●

 ● Curb Box