


### LABOR AND MATERIALS

Copper	}	Connection		\$	
Lead					
Curb	}	Cock	in.		
		Valve			
		T. S. & V.			
Service box	}	Short 3½ x 4½			
Old returned		Long 4½ x 5½			
				\$	
25 Ft.	}	Copper	in.		
3/4		<del>C.I.</del>			
		<del>C.I.</del>			
		Pipe at		\$	
Nipples		in. at		\$	
Bushings		to in. at		\$	
Red'g	}	Coupl'gs	to in. at		
Inc'g					
Union		in. at		\$	
Meter		in. at		\$	
				\$	
Compound Joints		at		\$	
Maintenance Foreman				\$	
Hrs. Water Maint. Man-1		at		\$	
Hrs. Water Maint. Man-2		at		\$	
Hrs. Garage Foreman		at		\$	
Hrs. Labor		at		\$	
Hrs. Compressor		at		\$	
				\$	
Trucking				\$	
Pav't Patch				\$	
				\$	
				\$	
				\$	
				\$	

St. Routh  
~~Pl.~~ Ave. No. 67

Name of Owner \_\_\_\_\_

Labor and Mat'l. Report 19 40

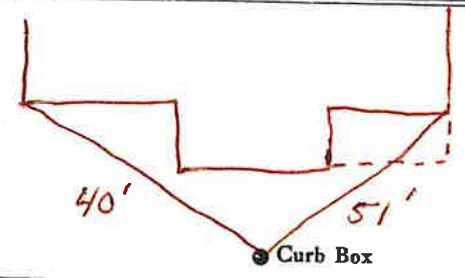

6" Main Elev. of Main at tap 4 1/2'

Gate at ● ● Gate at

● Curb Box