


LABOR AND MATERIALS

1	Copper	} Connection <u>9/4"</u>	\$
	Lead		
1	Curb	} in.	\$
	Cock		
	Valve		
		T.S. & V.	
1	Service box	} { Short 3 1/2 x 4 1/2 Long 4 1/2 x 5 1/2 Buff or Rdway }	\$
	Old returned		
?	Ft. in.	} { Copper C.I. C.I. }	Pipe at \$
	Nipples	in. at	\$
	Bushings	to in. at	\$
	Red'g	} Coupl'gs to in. at	\$
	Inc'g		
	Union	in. at	\$
	Meter	in. at	\$
	Lead Joints	at	\$
	Compound Joints	at	\$
	Maintenance Foreman		\$
	Hrs. Water Maint. Man—1	at	\$
	Hrs. Water Maint. Man—2	at	\$
	Hrs. Garage Foreman	at	\$
	Hrs. Labor—	at	\$
	Hrs. Compressor	at	\$
	Compensation Ins. at \$	per C	\$
	Trucking		\$
	Pav't Patch		\$
			\$
			\$
	O'head		\$
			\$

Fourth St. 69  
~~Pl.~~ Ave. No.

Name of Owner Tarantelli

Measured in Nov 30 1971  
 Labor and Mat'l. Report

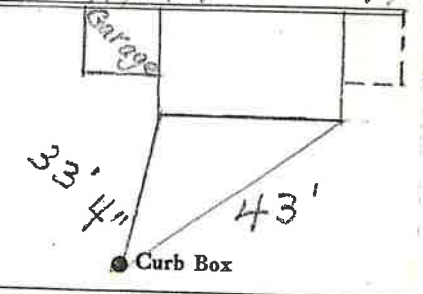

6" Main Elev. of Main at tap 5'

Gate at ● Gate at ●

● Curb Box