

LABOR AND MATERIALS

1 Copper } Connection 3 \$ _____
~~Lead~~ }
 1 Curb } Cock } 4
 } Valve } 3 in. \$ _____
 } T.S. & V. } 4
 1 Service box { Short $3\frac{1}{2} \times 4\frac{1}{2}$
 Old returned { Long $4\frac{1}{2} \times 5\frac{1}{2}$
 } Buff or Rdway } \$ _____
 2.5 Ft. 3 in. { Copper }
 } ~~Curb~~ } Pipe at \$ _____
 } 4 }
 } C.I. }
 Nipples _____ in. at \$ _____
 Bushings _____ to _____ in. at \$ _____
 Red'g }
 Inc'g } Coupl'gs _____ to _____ in. at \$ _____
 Union _____ in. at \$ _____
 Meter _____ in. at \$ _____
 Lead Joints at \$ _____
 Compound Joints at \$ _____
 Maintenance Foreman \$ _____
 Hrs. Water Maint. Man—1 at \$ _____
 Hrs. Water Maint. Man—2 at \$ _____
 Hrs. Garage Foreman _____ at \$ _____
 Hrs. Labor _____ at \$ _____
 Hrs. Compressor at \$ _____
 Compensation Ins. at \$ _____ per C \$ _____
 Trucking \$ _____
 Pay't Patch \$ _____
 _____ \$ _____
 _____ \$ _____
 _____ \$ _____
 O'head \$ _____
 _____ \$ _____

FOURTH


St. Pl. Ave. No. 71

Name of Owner

MELLON

Labor and Mat'l. Report

1940

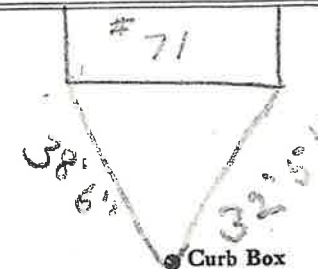

● Curb Box

6 Main

Elev. of Main at tap. 4 1/2

Gate at ●

● Gate at

● Curb Box