


LABOR AND MATERIALS

Copper	} Connection	_____	\$	_____
Lead				
Curb	} Cock Valve	_____ in.	\$	_____
Service box	} Short 3½ x 4½	_____	\$	_____
Ft.	} Copper	_____ in.	\$	_____
in.				
	C. I.	Pipe at	\$	_____
Nipples	_____ in.	at	\$	_____
Bushings	_____ to _____ in.	at	\$	_____
Red'g	} Coupl'gs	_____ to _____ in.	at	\$
Inc'g				
Union	_____ in.	at	\$	_____
Meter	_____ in.	at	\$	_____
Compound Joints	_____ at		\$	_____
Maintenance Foreman	_____ at		\$	_____
Hrs. Water Maint. Man-1	_____ at		\$	_____
Hrs. Water Maint. Man-2	_____ at		\$	_____
Hrs. Garage Foreman	_____ at		\$	_____
Hrs. Labor	_____ at		\$	_____
Hrs. Compressor	_____ at		\$	_____
Trucking	_____ at		\$	_____
Pav't Patch	_____ at		\$	_____
			\$	_____
			\$	_____
St. FOURTH
 Pl. _____
 Ave. No. 75

Name of Owner _____

Labor and Mat'l. Report 19

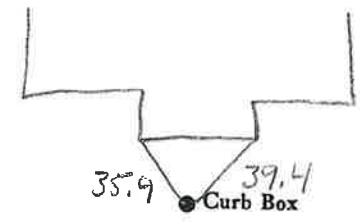

Main Elev. of Main at tap _____
 Gate at • • Gate at

25' to main

• Curb Box

MEASURED 1999

