

LABOR AND MATERIALS

1	Copper Lead	{ Connection	$\frac{3}{4}$	\$	1.31
1	Curb	{ Cock Valve T. S. & V.	$\frac{3}{4}$ in.	\$	1.75
1	Service Box Old returned	{ Short $3\frac{1}{2} \times 4\frac{1}{2}$ Long $4\frac{1}{2} \times 5\frac{1}{2}$ Buff. or Rdway		\$	1.60
9	Ft. $\frac{3}{4}$ in.	{ Copper Galv-Iron Cast Iron	Pipe at 18	\$	1.62
	Nipples	in. at		\$	
	Bushings	to in. at		\$	
	Red'g Inc'g	{ Couplings	to in. at	\$	
	Union	in. at		\$	
	Meter	in. at		\$	
	Lead Joints	at		\$	
	Leadite Joints	at		\$	
	Hrs. Foreman	at		\$	
	Hrs. Chauffeur	at		\$	
14	Hrs. Tapper	at	$\frac{62}{45}$	\$.16
$\frac{31}{2}$	Hrs. Labor	at	$\frac{45}{45}$	\$	1.58
	Hrs. Labor	at		\$	
	Hrs. Compressor	at		\$	
	Compensation Ins.			\$.06
	Trucking			\$	1.00
	Builders Use of Water	Before Paving		\$	
	Taps by Hoss-af			\$	
				\$	
				\$	
				\$	9.08

57 - - 1940

St. ?
Pr.
Ave. No. 76

Fourth

Name of Owner

Frank Thomas Est. Foot Top

Labor and Mat'l. Report

June 13 1940



● Curb Box

6" Main


Elev. of Main at tap $4\frac{1}{2}$

Gate at ●

● Gate at

9' to main

● Curb Box

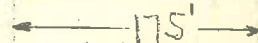

3' Hydrant