


LABOR AND MATERIALS

1	Copper	} Connection	3/4"	\$		
	Lead					
1	Curb	} Cock Valve T. S. & V.	3/4 in.	\$		
1	Service box	} { Short 3 1/2 x 4 1/2 Long 4 1/2 x 5 1/2 Buff or Rdway		\$		
	Old returned					
25	Ft.	} { Copper C.I. C.I.	Pipe at	\$		
	3/4" in.					
	Nipples	in.	at	\$		
	Bushings	to	in.	at	\$	
	Red'g	} Coupl'gs	to	in.	at	\$
	Inc'g					
	Union	in.	at	\$		
	Meter	in.	at	\$		
	Lead Joints	at		\$		
	Compound Joints	at		\$		
	Maintenance Foreman			\$		
	Hrs. Water Maint. Man-1	at		\$		
	Hrs. Water Maint. Man-2	at		\$		
	Hrs. Garage Foreman	at		\$		
	Hrs. Labor	at		\$		
	Hrs. Compressor	at		\$		
	Compensation Ins.	at \$	per C	\$		
	Trucking			\$		
	Pav't Patch			\$		
				\$		
				\$		
	O'head			\$		
				\$		

Fourth St St. Pl. Ave. No. 87

Name of Owner Paul Beaudin

Labor and Mat'l. Report July 1940

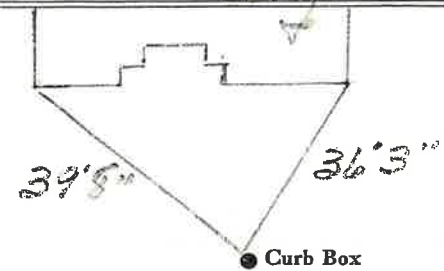

6" C.I. Main Elev. of Main at tap 5'

Gate at • Gate at •

● Curb Box

There is a Lot Top, made in 1940