

LABOR AND MATERIALS

Copper	}	Connection		\$	
Lead					
Curb	}	Cock	} in.	\$	
		Valve			
		T. S. & V.			
Service box Old returned	}	Short $3\frac{1}{2} \times 4\frac{1}{2}$	}	\$	
		Long $4\frac{1}{2} \times 5\frac{1}{2}$			
Ft.	}	Copper	} Pipe at	\$	
in.		G. I.			
		C. I.			
Nipples	in.	at		\$	
Bushings	to	in.	at	\$	
Red'g Inc'g	}	Coupl'gs	} to in.	at	\$
Union	in.	at		\$	
Meter	in.	at		\$	
				\$	
Compound Joints	at			\$	
Maintenance Foreman				\$	
Hrs. Water Maint. Man	—1	at		\$	
Hrs. Water Maint. Man	—2	at		\$	
Hrs. Garage Foreman		at		\$	
Hrs. Labor		at		\$	
Hrs. Compressor	at			\$	
				\$	
Trucking				\$	
Pav't Patch				\$	
				\$	
				\$	
				\$	
				\$	


FOURTH

St.
~~Pl.~~
Ave. No. 88

Name of Owner

Labor and Mat'l. Report

19

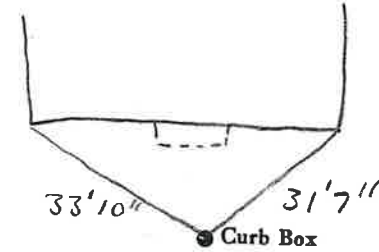

Main

Elev. of
Main at tap

Gate at ●

● Gate at

● Curb Box