

LABOR AND MATERIALS

1	Copper Lead	Connection	$\frac{3}{4}$	\$ 1.31
1	Curb	Cock Valve T. S. & V.	$\frac{3}{4}$ in.	\$ 1.75
1	Service Box	Old returned	Short $3\frac{1}{2} \times 4\frac{1}{2}$ Long $4\frac{1}{2} \times 5\frac{1}{2}$ Buff. or Rdway	\$ 1.66
9	Ft. $\frac{3}{4}$ in.	Copper Galv Iron Cast Iron	Pipe at 18	\$ 1.62
	Nipples	in. at		\$
	Bushings	to in. at		\$
	Red'g Inc'g	Couplings to in. at		\$
	Union	in. at		\$
	Meter	in. at		\$
	Lead Joints	at		\$
	Leadite Joints	at		\$
	Hrs. Foreman	at		\$
	Hrs. Chauffeur	at		\$
14	Hrs. Tapper	at	62 1/2	\$.16
	Hrs. Labor	at		\$
3 1/2	Hrs. Labor	at	45	\$ 1.58
	Hrs. Compressor	at		\$
	Compensation Ins.			\$.06
	Trucking			\$ 1.00
	Builders Use of Water	no Patch - E. U. T.		\$
	Tap by Hessel			\$
				\$
				\$
				\$
				\$
				\$ 9.08

92 -- 1940

St.

94

Pl.


Fourth (Lat) Ave. No. 88

Name of Owner

Thomas

Labor and Mat'l. Report

July 16 1946

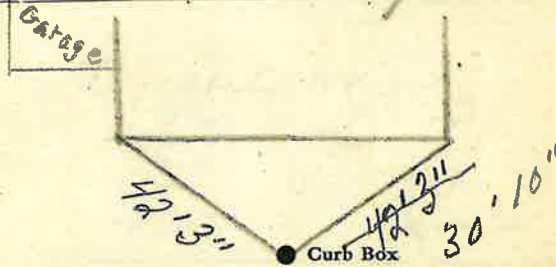

6 Main

Elev. of Main at tap 5

Gate at ●

● Gate at

● Curb Box