


LABOR AND MATERIALS

1	Copper } Connection $\frac{3}{4}$	\$
1	Lead } Cock	
1	Curb } Valve } $\frac{3}{4}$ in.	\$
	TS & V.	
1	Service box { Short 3-1/2 x 4-1/2	\$
	Old returned { Long 4-1/2 x 5-1/2	\$
8	Ft. $\frac{3}{4}$ in. { Copper } Pipe at	\$
	GI	
	GI	
	Nipples _____ in. at	\$
	Bushings _____ to _____ in. at	\$
	Red'g	
	Inc'g	
	Union _____ in. at	\$
	Meter _____ in. at	\$
	_____	\$
	Compound Joints at	\$
	Maintenance Foreman	\$
	Hrs. Water Maint. Man - 1 at	\$
	Hrs. Water Maint. Man - 2 at	\$
	Hrs. Garage Foreman _____ at	\$
	Hrs. Labor _____ at	\$
	Hrs. Compressor at	\$
	_____	\$
	Trucking	\$
	Pav't Patch	\$
	_____	\$
	_____	\$
St. FOURTH
 Ave. No. 11
 Name of Owner _____

Labor and Mat'l. Report 1934, OCT. 15

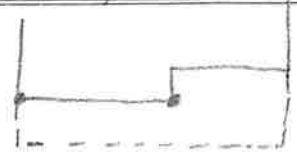

23'11" 23'11"

● Curb Box

6" Main Elev. of Main at tap 5'
 Gate at ● ● Gate at

8' to main

3/4" Copper ● Curb Box

OLD SHUT OFF AT MAIN

LENA CASH