


LABOR AND MATERIALS

1	Copper	} Connection ^{3/4"}	\$
1	Lead		\$
1	Curb	} Cock Valve T.S. & V. } ^{3/4} in.	\$
1	Service box		} { Short 3 1/2 x 4 1/2 } } { Long 4 1/2 x 5 1/2 } } { Buff or Rdway }
25	Pt. ^{3/4} in.	} { Copper } } { G.I. } } { C.I. }	
	Nipples		in. at \$
	Bushings	to in. at \$	
	Red'g } Inc'g }	} Coupl'gs to in. at \$	
	Union		in. at \$
	Meter	in. at \$	
	Lead Joints	at \$	
	Compound Joints	at \$	
	Maintenance Foreman	\$	
	Hrs. Water Maint. Man-1	at \$	
	Hrs. Water Maint. Man-2	at \$	
	Hrs. Garage Foreman	at \$	
	Hrs. Labor	at \$	
	Hrs. Compressor	at \$	
	Compensation Ins.	at \$ per C \$	
	Trucking	\$	
	Pav't Patch	\$	
	Top by Hessel	\$	
		\$	
		\$	
	O'head	July 1940 where St. was Paed.	\$
		\$	

St. PL
Ave. No. 97
Fourth
Name of Owner Nelson Chamiere

Labor and Mat'l. Report July 1940

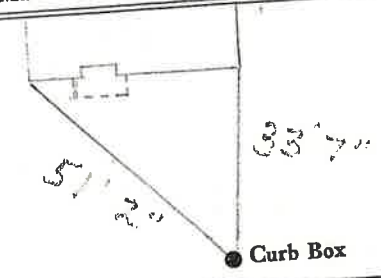

6" Main
Elev. of Main at tap
Gate at • Gate at •

Lot Map • Curb Box
Measured in. 7. 21-67