


LABOR AND MATERIALS

| | | | | | |
|----|--|---|--------------------|----|--|
| 1 | Copper brass | Connection | $\frac{3}{4}$ 4 | \$ | |
| 1 | Curb | Cock Valve T.S. - 2" x 1" | $\frac{3}{4}$ in. | \$ | |
| 1 | Service box Old returned | Short 3-1/2 x 4-1/2 long 4-1/2 x 5-1/2 | | \$ | |
| 32 | Ft. | $\frac{3}{4}$ in. Copper Gal. St. | Pipe at | \$ | |
| | Nipples | | in. at | \$ | |
| | Bushings | | to in. at | \$ | |
| | Red'g | | | \$ | |
| | Inc'g | | | \$ | |
| | Union | | in. at | \$ | |
| | Meter | | in. at | \$ | |
| | | | | \$ | |
| | Compound Joints at | | | \$ | |
| | Maintenance Foreman | | | \$ | |
| | Hrs. Water Maint. Man - 1 at | | | \$ | |
| | Hrs. Water Maint. Man - 2 at | | | \$ | |
| | Hrs. Garage Foreman | | at | \$ | |
| | Hrs. Labor | | at | \$ | |
| | Hrs. Compressor at | | | \$ | |
| | | | | \$ | |
| | Trucking | | | \$ | |
| | Pav't Patch | | | \$ | |
| | | | | \$ | |
| | | | | \$ | |
| | | | | \$ | |
| | | | | \$ | |

FOWLER ~~ST~~
Ave. No. _____

Name of Owner
FITZGERALD

Labor and Mat'l. Report 1932, MAY

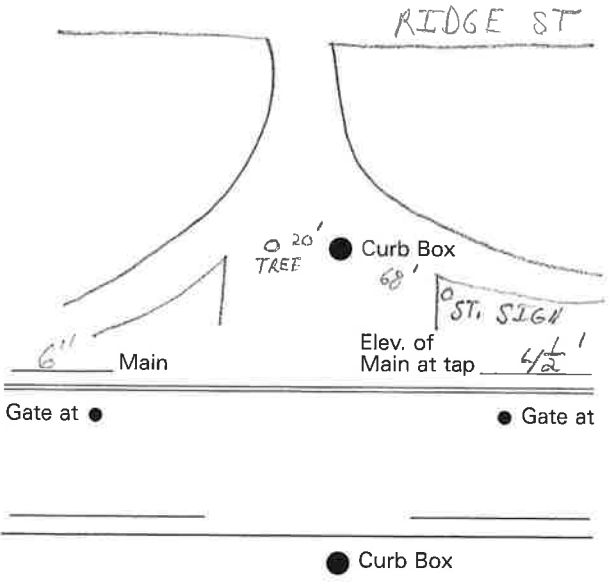

Gate at ● Gate at ●

● Curb Box