


LABOR AND MATERIALS

Copper	} Connection	_____	\$ _____
Lead			
Curb	} Cock Valve T. S. & V. }	_____ in.	\$ _____
Service box		} Short 3½ x 4½ Long 4½ x 5½ }	_____
Old returned			_____
Ft. ^{3/4} in.	} Copper G.I. C.I. }	Pipe at _____	\$ _____
Nipples		_____ in. at _____	\$ _____
Bushings	_____ to _____ in.	at _____	\$ _____
Red'g	} Coupl'gs	_____ to _____ in.	at _____
Inc'g			
Union	_____ in.	at _____	\$ _____
Meter	_____ in.	at _____	\$ _____
Compound Joints	at _____	\$ _____	
Maintenance Foreman	_____	\$ _____	
Hrs. Water Maint. Man—1	at _____	\$ _____	
Hrs. Water Maint. Man—2	at _____	\$ _____	
Hrs. Garage Foreman	at _____	\$ _____	
Hrs. Labor	_____ at _____	\$ _____	
Hrs. Compressor	at _____	\$ _____	
Trucking	_____	\$ _____	
Pav't Patch	_____	\$ _____	
		\$ _____	
		\$ _____	
St. PT.
Ave. No. 12

Name of Owner _____

Labor and Mat'l. Report 1971

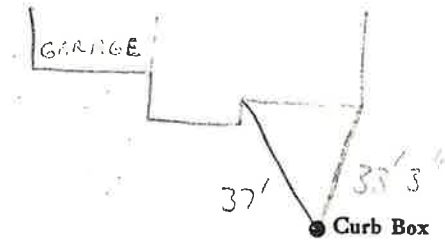

Main _____ Elev. of Main at tap _____
Gate at • _____ Gate at • _____

• Curb Box