


LABOR AND MATERIALS

Copper } Connection		\$
Lead } }		
Curb } Cock		
} Valve	in.	\$
} T. S. & V.		
Service box } Short 3½ x 4½		
Old returned } Long 4½ x 5½		\$
Ft. 3/4 in. } Copper		
} G.I.	Pipe at	\$
} G.I.		
Nipples	in. at	\$
Bushings	to in. at	\$
Red'g }		
Inc'g } Coupl'gs	to in. at	\$
Union	in. at	\$
Meter	in. at	\$
		\$
Compound Joints	at	\$
Maintenance Foreman		\$
Hrs. Water Maint. Man-1	at	\$
Hrs. Water Maint. Man-2	at	\$
Hrs. Garage Foreman	at	\$
Hrs. Labor	at	\$
Hrs. Compressor	at	\$
		\$
Trucking		\$
Pav't Patch		\$
		\$
		\$
St. FRANKLIN  
~~PI.~~  
 Ave. No. 22

Name of Owner \_\_\_\_\_

Labor and Mat'l. Report 19 94

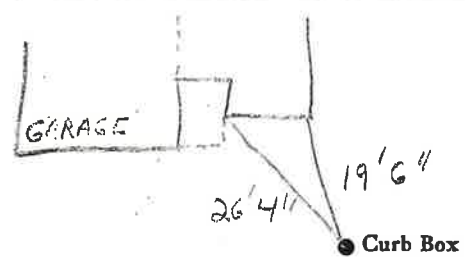

Main Elev. of Main at tap \_\_\_\_\_

Gate at ● ● Gate at

● Curb Box


LABOR AND MATERIALS

Copper } Connection _____	\$ _____
Lead } _____	
Curb } Cock _____	\$ _____
} Valve _____	
} T. S. & V. _____	in. _____
Service box { Short 3½ x 4½ }	
Old returned { Long 4½ x 5½ }	\$ _____
Ft. 3/4 in. { Copper } Pipe at _____	\$ _____
} <del>C.I.</del>	
} <del>C.I.</del>	
Nipples _____ in. at _____	\$ _____
Bushings _____ to _____ in. at _____	\$ _____
Red'g } Coupl'gs _____ to _____ in. at _____	\$ _____
Inc'g } _____	
Union _____ in. at _____	\$ _____
Meter _____ in. at _____	\$ _____
_____	\$ _____
Compound Joints at _____	\$ _____
Maintenance Foreman _____	\$ _____
Hrs. Water Maint. Man—1 at _____	\$ _____
Hrs. Water Maint. Man—2 at _____	\$ _____
Hrs. Garage Foreman _____ at _____	\$ _____
Hrs. Labor _____ at _____	\$ _____
Hrs. Compressor at _____	\$ _____
_____	\$ _____
Trucking _____	\$ _____
Pav't Patch _____	\$ _____
_____	\$ _____
_____	\$ _____
_____	\$ _____
_____	\$ _____

St. FRANKLIN  
 Pt.             
 Ave. No. 22

Name of Owner \_\_\_\_\_  
 \_\_\_\_\_

Labor and Mat'l. Report \_\_\_\_\_ 1973

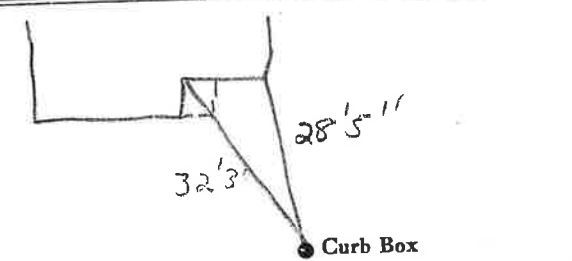

Main \_\_\_\_\_ Elev. of Main at tap \_\_\_\_\_  
 Gate at ● \_\_\_\_\_ Gate at ● \_\_\_\_\_

● Curb Box