


LABOR AND MATERIALS

Copper } Connection	_____	\$ _____
Lead } Cock	_____	\$ _____
Curb } Valve	_____ in.	\$ _____
	T. S. & V.	
Service box } Short 3½ x 4½	_____	\$ _____
Old returned } Long 4½ x 5½	_____	\$ _____
46' Ft. 3/4 in. } Copper	_____	\$ _____
	G.I.	
	G.I.	
	} Pipe at	\$ _____
Nipples	_____ in. at _____	\$ _____
Bushings	_____ to _____ in. at _____	\$ _____
Red'g }	_____	\$ _____
Inc'g }	Coupl'gs. _____ to _____ in. at _____	\$ _____
Union	_____ in. at _____	\$ _____
Meter	_____ in. at _____	\$ _____
		\$ _____
Compound Joints	_____ at _____	\$ _____
Maintenance Foreman	_____	\$ _____
Hrs. Water Maint. Man-1	_____ at _____	\$ _____
Hrs. Water Maint. Man-2	_____ at _____	\$ _____
Hrs. Garage Foreman	_____ at _____	\$ _____
Hrs. Labor	_____ at _____	\$ _____
Hrs. Compressor	_____ at _____	\$ _____
		\$ _____
Trucking	_____	\$ _____
Pav't Patch	_____	\$ _____
		\$ _____
		\$ _____
St. FRANKLIN Ave. No. 24
 Name of Owner _____

Labor and Mat'l. Report 1974

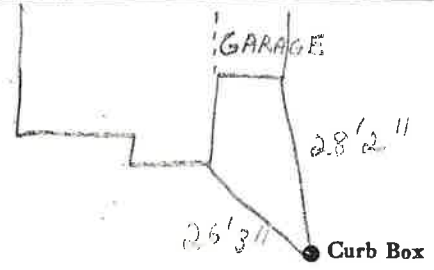

Main Elev. of Main at tap _____
 Gate at • Gate at •

• Curb Box