


LABOR AND MATERIALS

Copper } Connection		\$
Lead }		
Curb } Cock	} in.	\$
Valve		
T. S. & V.		
Service box } Short 3 1/2 x 4 1/2	}	\$
Old returned } Long 4 1/2 x 5 1/2		
Ft. 3/4 in. } Copper	} Pipe at	\$
Nipples	in. at	\$
Bushings	to in. at	\$
Red'g } Coupl'gs	to in. at	\$
Inc'g }		
Union	in. at	\$
Meter	in. at	\$
Compound Joints	at	\$
Maintenance Foreman		\$
Hrs. Water Maint. Man-1	at	\$
Hrs. Water Maint. Man-2	at	\$
Hrs. Garage Foreman	at	\$
Hrs. Labor	at	\$
Hrs. Compressor	at	\$
Trucking		\$
Pav't Patch		\$
		\$
		\$
St. FRANKLIN  
 Pl. " Ave. No. 26

Name of Owner

Labor and Mat'l. Report 1994

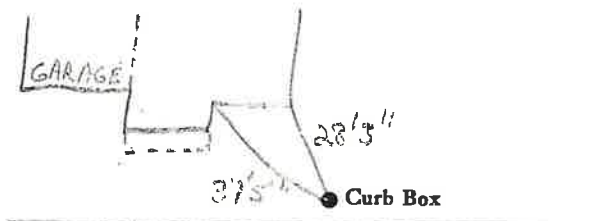

Main Elev. of Main at tap  
 Gate at • Gate at •

• Curb Box