


LABOR AND MATERIALS

Copper	} Connection	_____	\$ _____
Lead			
Curb	} Cock Valve T. S. & V.	_____ in.	\$ _____
Service box	} Short 3 1/2 x 4 1/2 Long 4 1/2 x 5 1/2	_____	\$ _____
Old returned			
27' Ft.	} Copper G.I. C.I.	3/4 in.	Pipe at \$ _____
Nipples	_____ in. at _____	\$ _____	
Bushings	_____ to _____ in. at _____	\$ _____	
Red'g Inc'g	} Coupl'gs. _____ to _____ in. at _____	\$ _____	
Union		_____ in. at _____	\$ _____
Meter	_____ in. at _____	\$ _____	
		\$ _____	
Compound Joints	at _____	\$ _____	
Maintenance Foreman		\$ _____	
Hrs. Water Maint. Man-1	at _____	\$ _____	
Hrs. Water Maint. Man-2	at _____	\$ _____	
Hrs. Garage Foreman	at _____	\$ _____	
Hrs. Labor	_____ at _____	\$ _____	
Hrs. Compressor	at _____	\$ _____	
		\$ _____	
Trucking		\$ _____	
Pav't Patch		\$ _____	
		\$ _____	
		\$ _____	
		\$ _____	

St. _____
Pl. _____
Ave. No. 27

Name of Owner _____

Labor and Mat'l. Report _____ 19 93

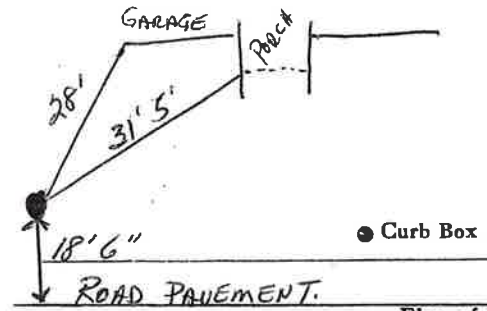

_____ Elev. of Main at tap _____
Main _____
Gate at ● _____ ● Gate at _____

● Curb Box

LSM-5C-6-1-67

LOCATION MARKED 10/14/03