


LABOR AND MATERIALS

Copper } Connection		\$	
Lead } Connection		\$	
Curb } Cock	} in.	\$	
Curb } Valve			
Curb } T. S. & V.			
Service box } Short 3 1/2 x 4 1/2	}	\$	
Old returned } Long 4 1/2 x 5 1/2			
Ft. 3/4 in. } Copper	} Pipe at	\$	
			G.I.
			C.I.
Nipples	in. at	\$	
Bushings	to in. at	\$	
Red'g } Coupl'gs	} to in. at	\$	
Inc'g }			
Union	in. at	\$	
Meter	in. at	\$	
		\$	
Compound Joints	at	\$	
Maintenance Foreman		\$	
Hrs. Water Maint. Man-1	at	\$	
Hrs. Water Maint. Man-2	at	\$	
Hrs. Garage Foreman	at	\$	
Hrs. Labor	at	\$	
Hrs. Compressor	at	\$	
		\$	
Trucking		\$	
Pav't Patch		\$	
		\$	
		\$	
St. FRANKLIN
 Pl. 29
 Ave. No. 29

Name of Owner _____

Labor and Mat'l. Report 19 93

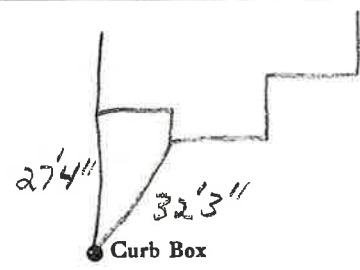

Main Elev. of Main at tap

Gate at • Gate at

• Curb Box